

**APPLICATION FOR PERMIT**  
**COUNTY OF LOS ANGELES**  
**DEPARTMENT OF COUNTY ENGINEER**  
**BUILDING AND SAFETY DIVISION**  
JOHN A. LAMBIE, County Engineer  
COLEMAN W. JENKINS, Sup't. of Building

**SEWER-SEWAGE DISPOSAL**

**1**

**FOR APPLICANT TO FILL IN**

LEGAL DESCRIPTION	LOT NO.	19
BLOCK	TRACT	10 4748
SIZE OF LOT	NO. OF BLDGS NOW ON LOT	Single Residence 1
USE OF BUILDINGS		Single Residence
CONTRACTOR		Paul E. Bills
ADDRESS		7245 Katherine St.
CITY	TEL. NO.	Van Nuys 875-2433
LICENSE NO.	LICENSE CLASS	102423 C-21
NO.	DESCRIPTION OF WORK	FEE
	HOUSE SEWER CONNECTING TO PUBLIC SEWER	@ \$ 5.00
	SEPTIC TANK, SEEPAGE PIT OR PITS AND/OR DRAINFIELD	@ \$10.00
	HOUSE SEWER CONNECTING TO PRIVATE DISPOSAL SYSTEM	@ \$ 3.00
	CONNECT ADDITIONAL BLDG. OR WORK TO HOUSE SEWER	@ \$ 3.00
1	ALTER, REPAIR OR ABANDON HOUSE SEWER OR DISPOSAL SYSTEM	@ \$ 3.00
	OVERFLOW SEEPAGE PIT, DRAINFIELD EXTN., CESSPOOL, MANHOLE	@ \$ 5.00
	PERCOLATION TEST	@ \$ 5.00
		3.00

BUILDING ADDRESS	962 So. <del>Whittier</del> Eastern
LOCALITY	E. L. A.
NEAREST CROSS ST.	Whittier
OWNER	Harbor Oil Co.
MAIL ADDRESS	501 So. Boylston
CITY	L. A.
TEL. NO.	

DISTRICT NO.	GROUP	BK	MAP	PG	PROCESSED BY
6	I	B	17		Plummer

<b>CONNECTION DATA</b>			
STATION	12+06	DEPTH	6
MANHOLE REFERENCE	132.0 S OF	UPPER LOWER	
TYPE OF CONNECTION	CURB	P.L.	LENGTH FROM M.L. TO P.L. 3
CO. IMP. NO.	484	P.C. NO.	JOB NO.
TRUNK PERMIT NO.		ROAD PERMIT NO.	
AFFIDAVIT	WAIVER	EASEMENT	RECORD. INSTR. NO. DATE
HWY. OR ST. WIDENING			
STATE ENCROACHMENT PERMIT NO. <del>ADD #1</del> 68714			
INDUSTRIAL WASTE APPROVAL			

<b>OWNER'S AUTHORIZATION</b>	PERMIT	\$	2 00
	TOTAL FEE		5.00

I HAVE AT THIS DATE A CONTRACT WITH THE HEREIN NAMED CONTRACTOR TO CONNECT THE ABOVE DESCRIBED EXISTING DWELLING TO THE PUBLIC SEWER.

SIGNED THIS 10 DAY OF March 1966  
OWNER OR OWNERS AGENT Paul E. Bills

ADDRESS \_\_\_\_\_

I HEREBY ACKNOWLEDGE THAT I HAVE READ THIS APPLICATION AND STATE THAT THE ABOVE IS CORRECT AND AGREE TO COMPLY WITH ALL COUNTY ORDINANCES AND STATE LAWS REGULATING PLUMBING AND SEWERS.

I HEREBY CERTIFY THAT I AM PROPERLY REGISTERED AND/OR LICENSED AS REQUIRED BY LOS ANGELES COUNTY AND STATE OF CALIFORNIA OR THAT I AM THE LEGAL OWNER OF AND INTEND TO RESIDE IN, THE ABOVE DESCRIBED RESIDENTIAL PROPERTY.

SIGNATURE OF PERMITTEE Paul E. Bills

<b>CHARGES</b>	
CONNECTION CHARGE FEE	
REIMBURSEMENT FEE	

<b>APPROVALS</b>		DATE	INSPECTOR'S SIGNATURE
NEW HOUSE SEWER			
CONNECT ADDITIONAL BUILDING OR WORK			
SEPTIC TANK, SEEP, PIT(S) AND/OR DRAINFIELD			
CESSPOOL <input type="checkbox"/> DRYWELL <input type="checkbox"/>			
ALTER, REPAIR, SEWER OR SEWAGE DISPOSAL SYSTEM			
DISCONNECT PLUG AND ABANDON HOUSE SEWER			
BACKFILL SEPTIC TANKS <input type="checkbox"/> SEEP, PIT(S) <input type="checkbox"/> CESSPOOLS <input type="checkbox"/>			

**VALIDATION**

CK. M. O. CASH


1607948 MAR 1 0 A 5.00

INSPECTOR COPY

FOR DEPARTMENT USE

REQUIRED INFORMATION

1. INDICATE ALL BUILDINGS ON PROPERTY.
2. INDICATE AND DIMENSION SEWAGE DISPOSAL SYSTEM WITH TIE DISTANCES TO BUILDINGS AND PROPERTY LINES.
3. INDICATE SIZE OF SEPTIC TANK—DEPTH OF SEEPAGE PIT(S)—SIZE OF CESSPOOL(S).
4. INDICATE NORTH DIRECTION ON PLOT.
5. INDICATE BOTH STREETS IF CORNER.

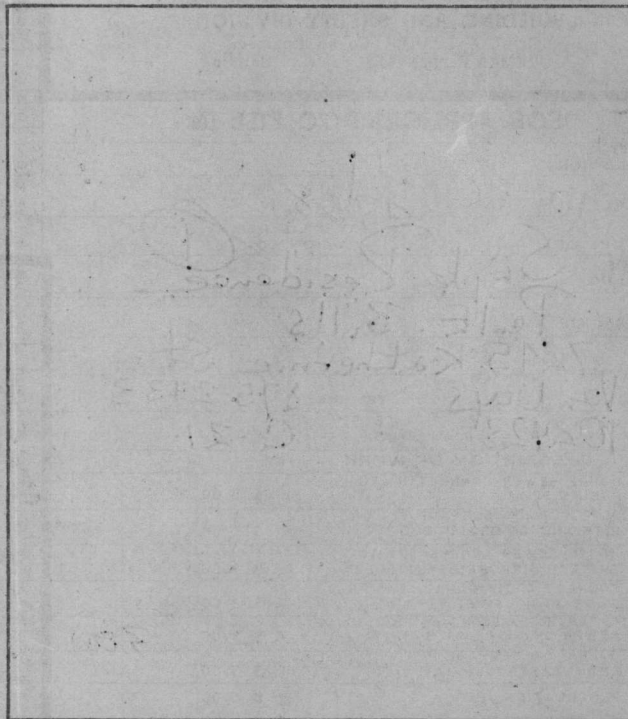

ST. ALLEY R/W

FIELD NOTES